
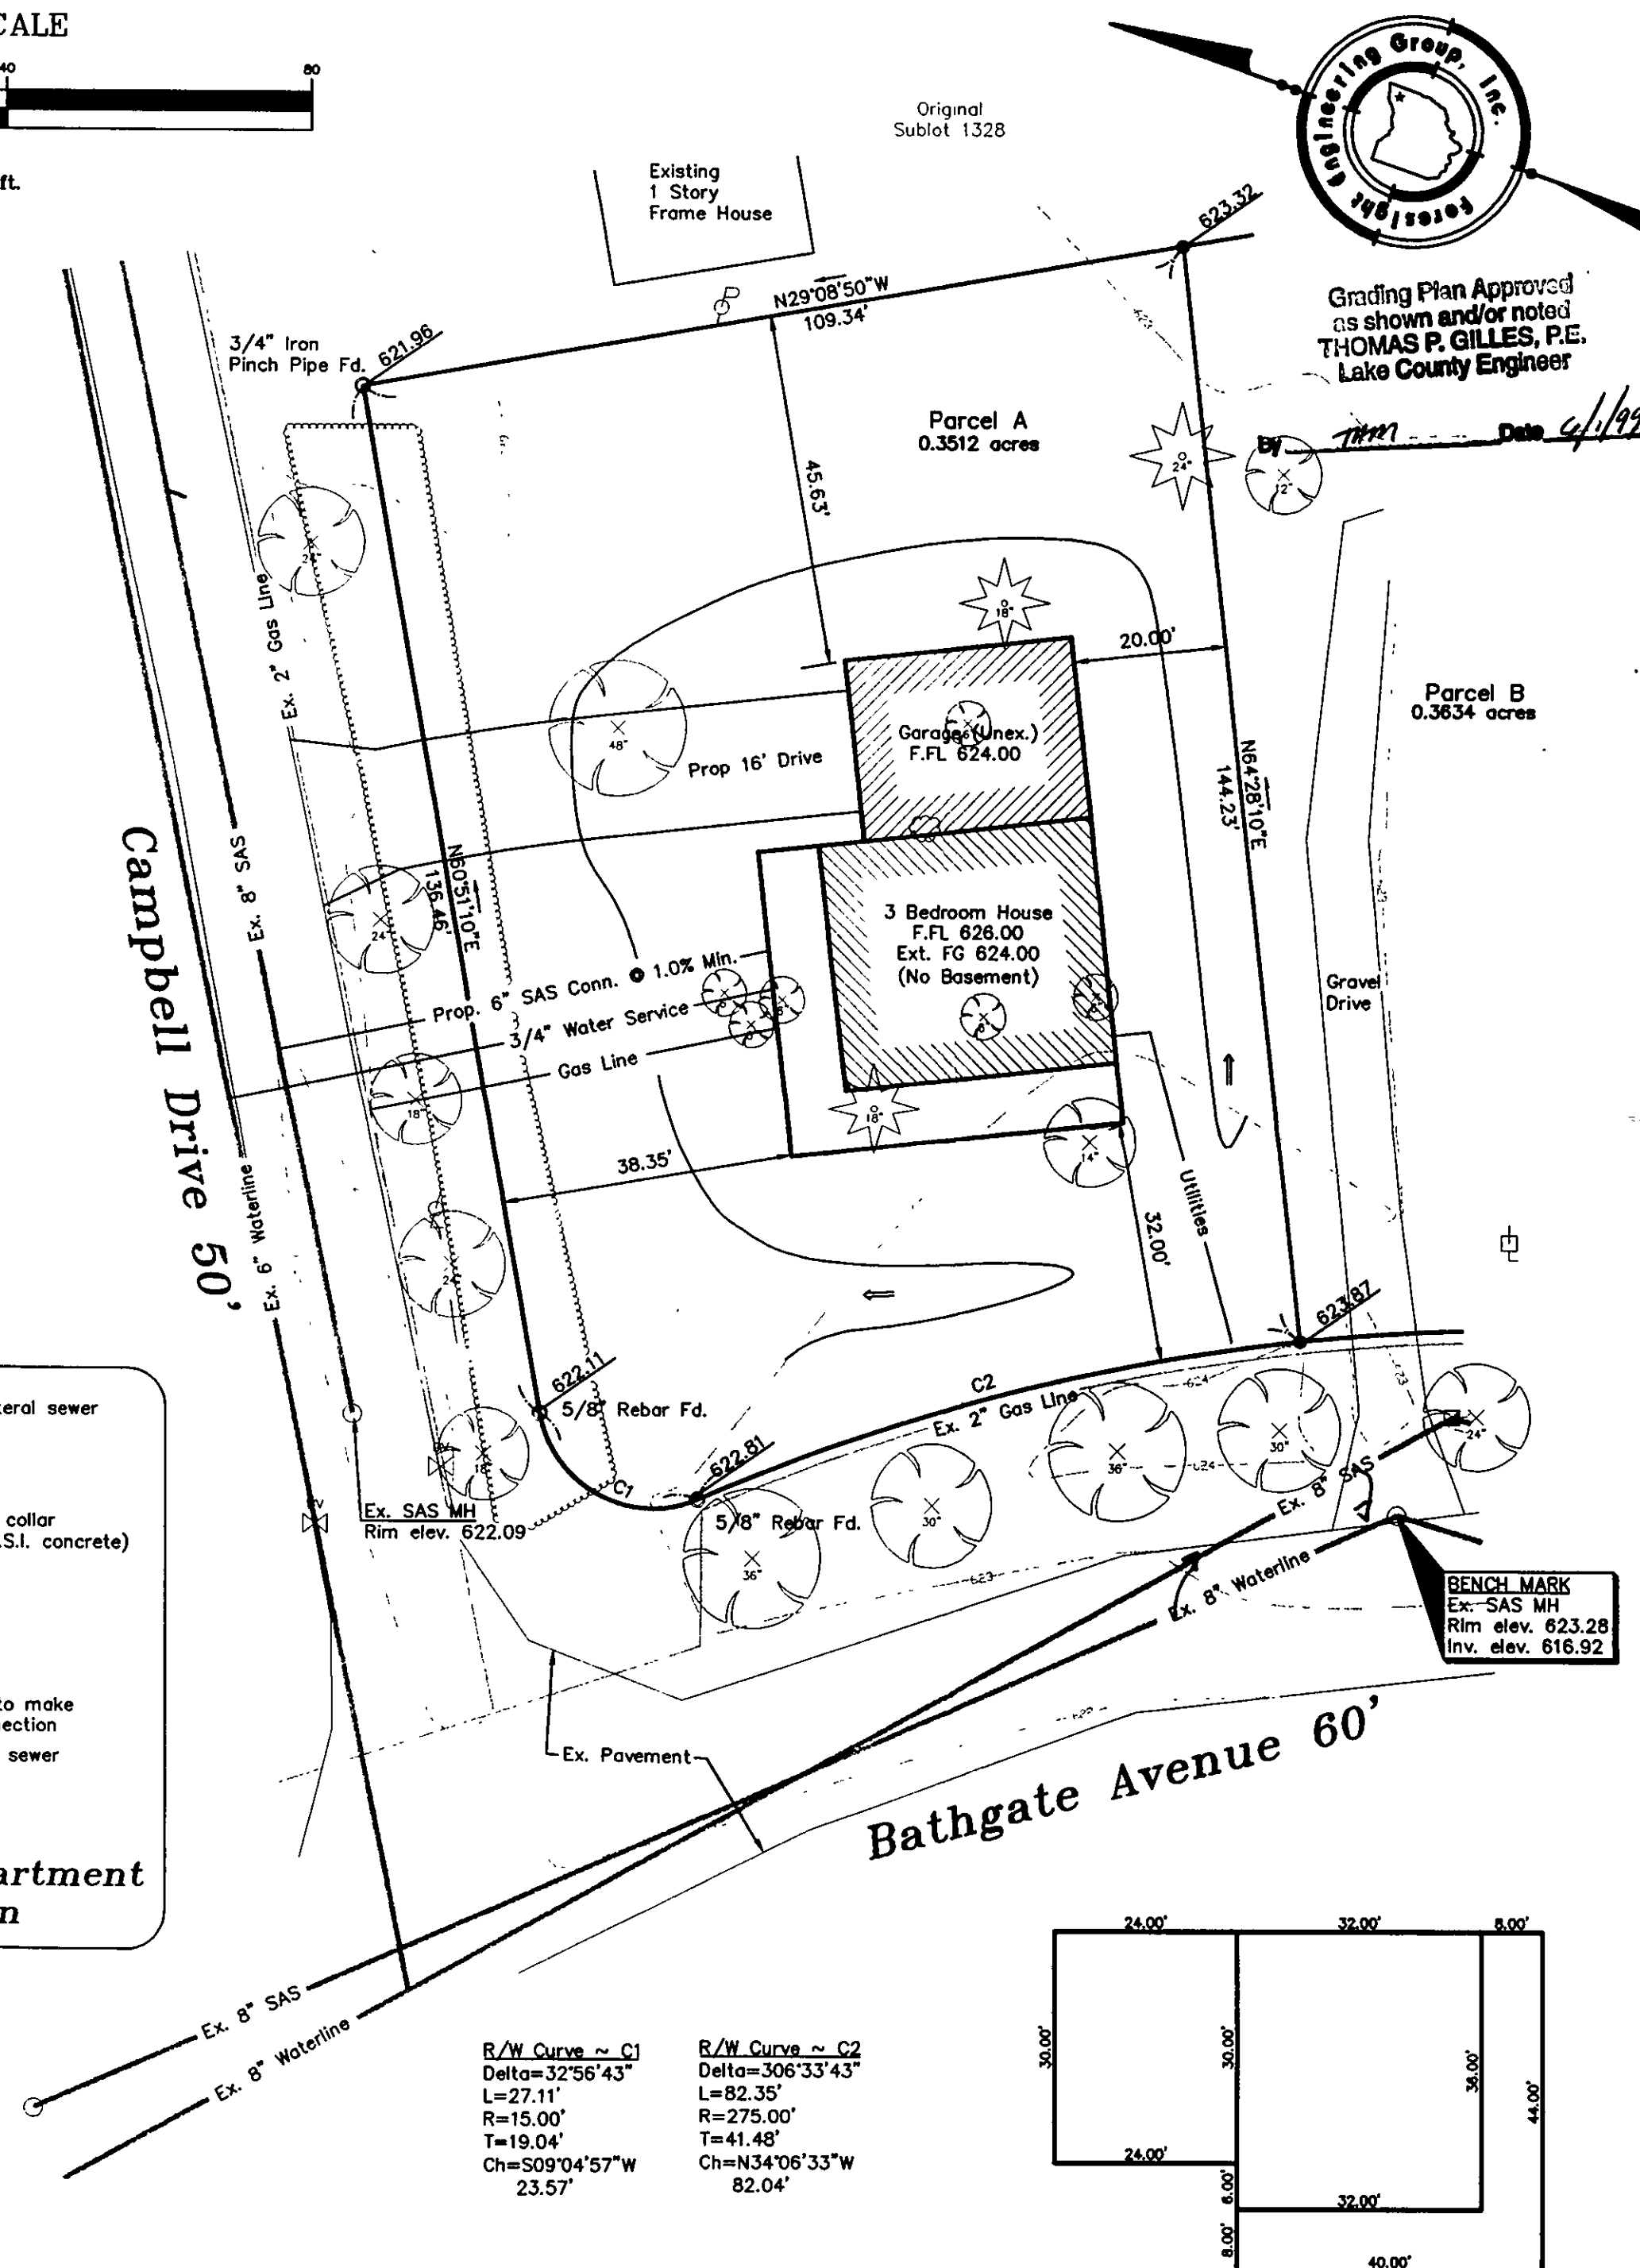


SYMBOL LEGEND	
	Iron Pin Set
	Hub Set
	Water Valve
	Manhole
	Gas Valve
	Iron Pin Found
	Guy Wire
	Light Pole
	Water Meter
	Yard Light
	Bush
	Mail Box
	Fire Hydrant
	Sign
	Power Pole

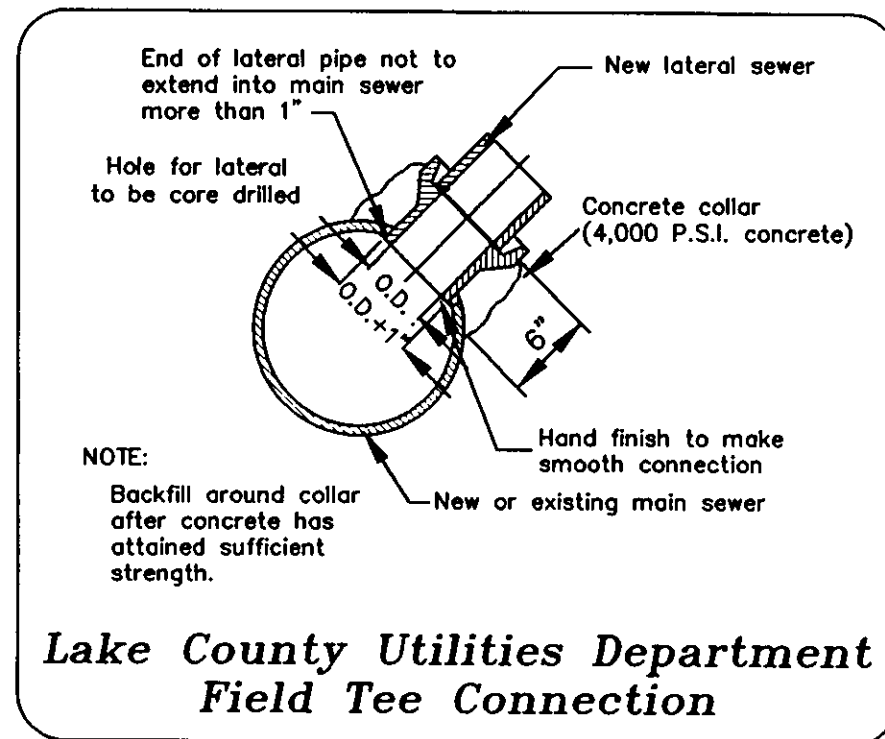

**SITE PLAN**  
for : Carmin Arcadi  
CLIENT  
ADDRESS \_\_\_\_\_ CITY \_\_\_\_\_ STATE Ohio ZIP \_\_\_\_\_

**A**  
SUBLOT No. \_\_\_\_\_ SUBDIVISION NAME \_\_\_\_\_ VOL. \_\_\_\_\_ PAGE \_\_\_\_\_  
LOT \_\_\_\_\_ TRACT \_\_\_\_\_ Madison Twp. CITY \_\_\_\_\_ STATE Ohio

**Foresight Engineering Group**  
**Engineers & Surveyors**  
440 286-1010  
440 286-1034 fax  
320 Center Street, Unit F  
Chardon, Ohio 44024

**DESIGN CERTIFICATION**  
This Site Plan was prepared by Foresight Engineering Group, Inc., and is correct to the best of my knowledge and belief.  
Sam A. Ram  
NAME

<b>CHECK LIST</b> LOT DIMENSIONS & BEARINGS TIE TO NEAREST STREET SUBLOT No. (PARCEL No.) SURROUNDING OWNERS BUILDING DIMENSIONS SETBACK, SIDEYARD, REARYARD FINISH GRADES DRIVE & APRON TYPE, WIDTH, THICKNESS SIDEWALK TYPE, WIDTH, THICKNESS CULVERT TYPE, DIAM., LENGTH WATER MAIN SIZE, LOCATION SAN. SEWER SIZE, % GRADE, LOC. SAN. MH. CAST. ELEV., INV. ELEV. SAN. CONN. SIZE, % GRADE, LOC. STORM SEWER SIZE, % GRADE, LOC. STORM MH. CAST. ELEV., INV. ELEV. PAV'T TYPE, GRADE, CURBS GAS LINE LOC., SIZE SEPTIC SYSTEM & DUPLICATION WELL LOCATION & ISOLATION RADIUS	
--	--

STATE SEAL

**"AS BUILT" CERTIFICATION**  
I hereby certify that the circled information is existing as obtained on the site \_\_\_\_\_ 19\_\_\_\_ and is correct to the best of my knowledge and belief.  
NAME \_\_\_\_\_

SCALE : 1" = 20'	1
FILE NAME: I:\Arc19902\S\L-A	2
DATE : May 19, 1999	3

**BENCHMARK:** Sanitary Manhole Rim Elev. = 623.28

"I, the undersigned hereby certify that this topography, indicated by 6", 1' or 2' contours, and the elevations shown hereon represent an actual field survey made by Foresight Engineering Group, Inc. on the 27 day of March 1999 and that the elevations were taken at appropriate intervals and that as of that date they existed as indicated hereon."

Sam A. Ram  
NAME  
APPROVED  
MADISON TOWNSHIP ZONING  
DATE 5/27/99  
BY ML 16222

**EXISTING UNDERGROUND UTILITIES NOTES:**  
The location both horizontal and vertical of the underground utilities shown hereon, have been obtained by a diligent and comprehensive search of available records. Verification by field observation, has been conducted where practical. However, Foresight Engineering Group, Inc. does not guarantee the completeness nor accuracy thereof.

CALL TOLL FREE 800-362-2764  
OHIO UTILITIES PROTECTION SERVICE